




PROFILO - ELEVATION

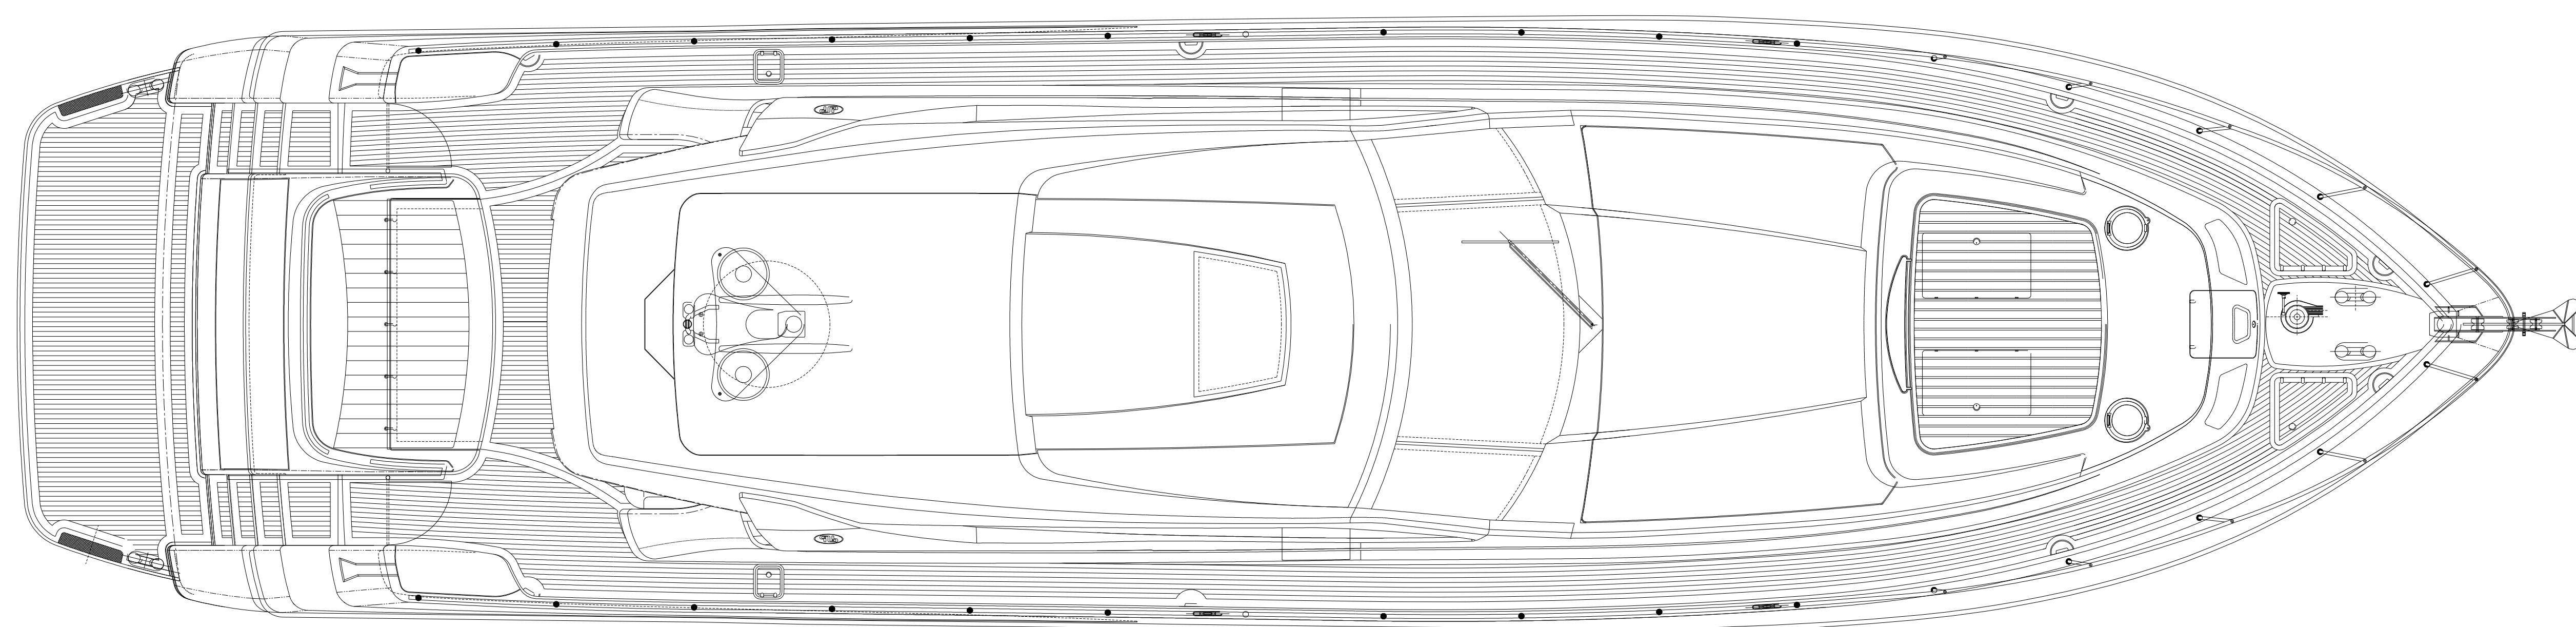


PIANTA PONTE DI COPERTA - MAIN DECK

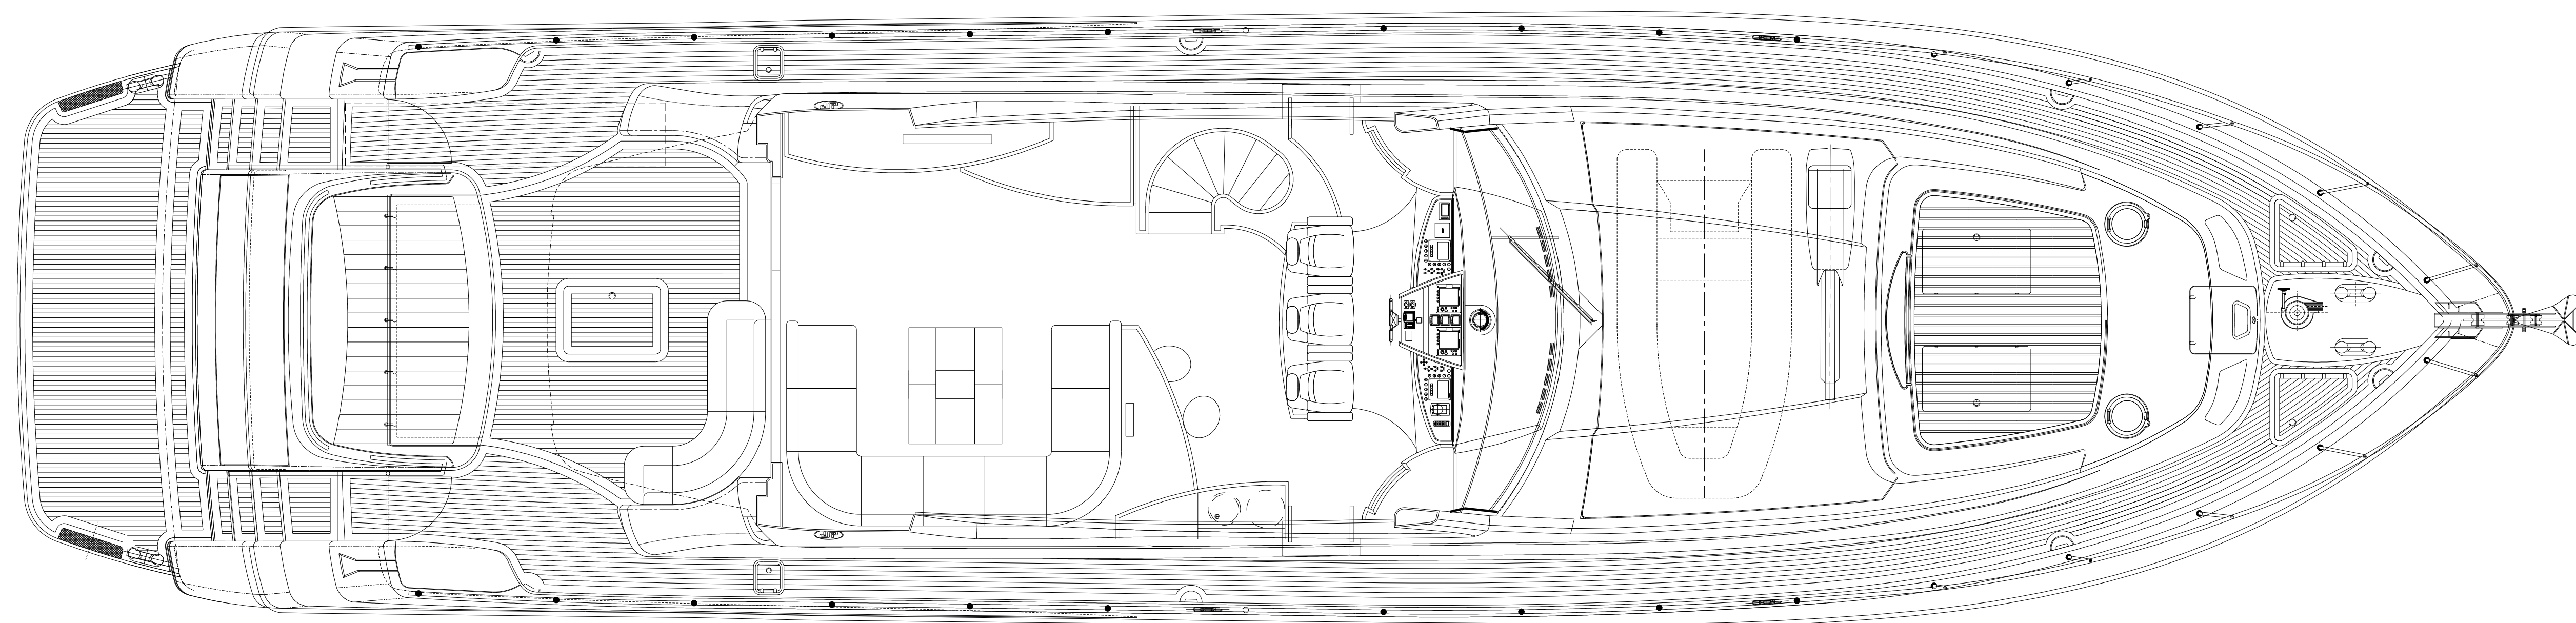

PIANTA PONTE DI COPERTA - MAIN DECK

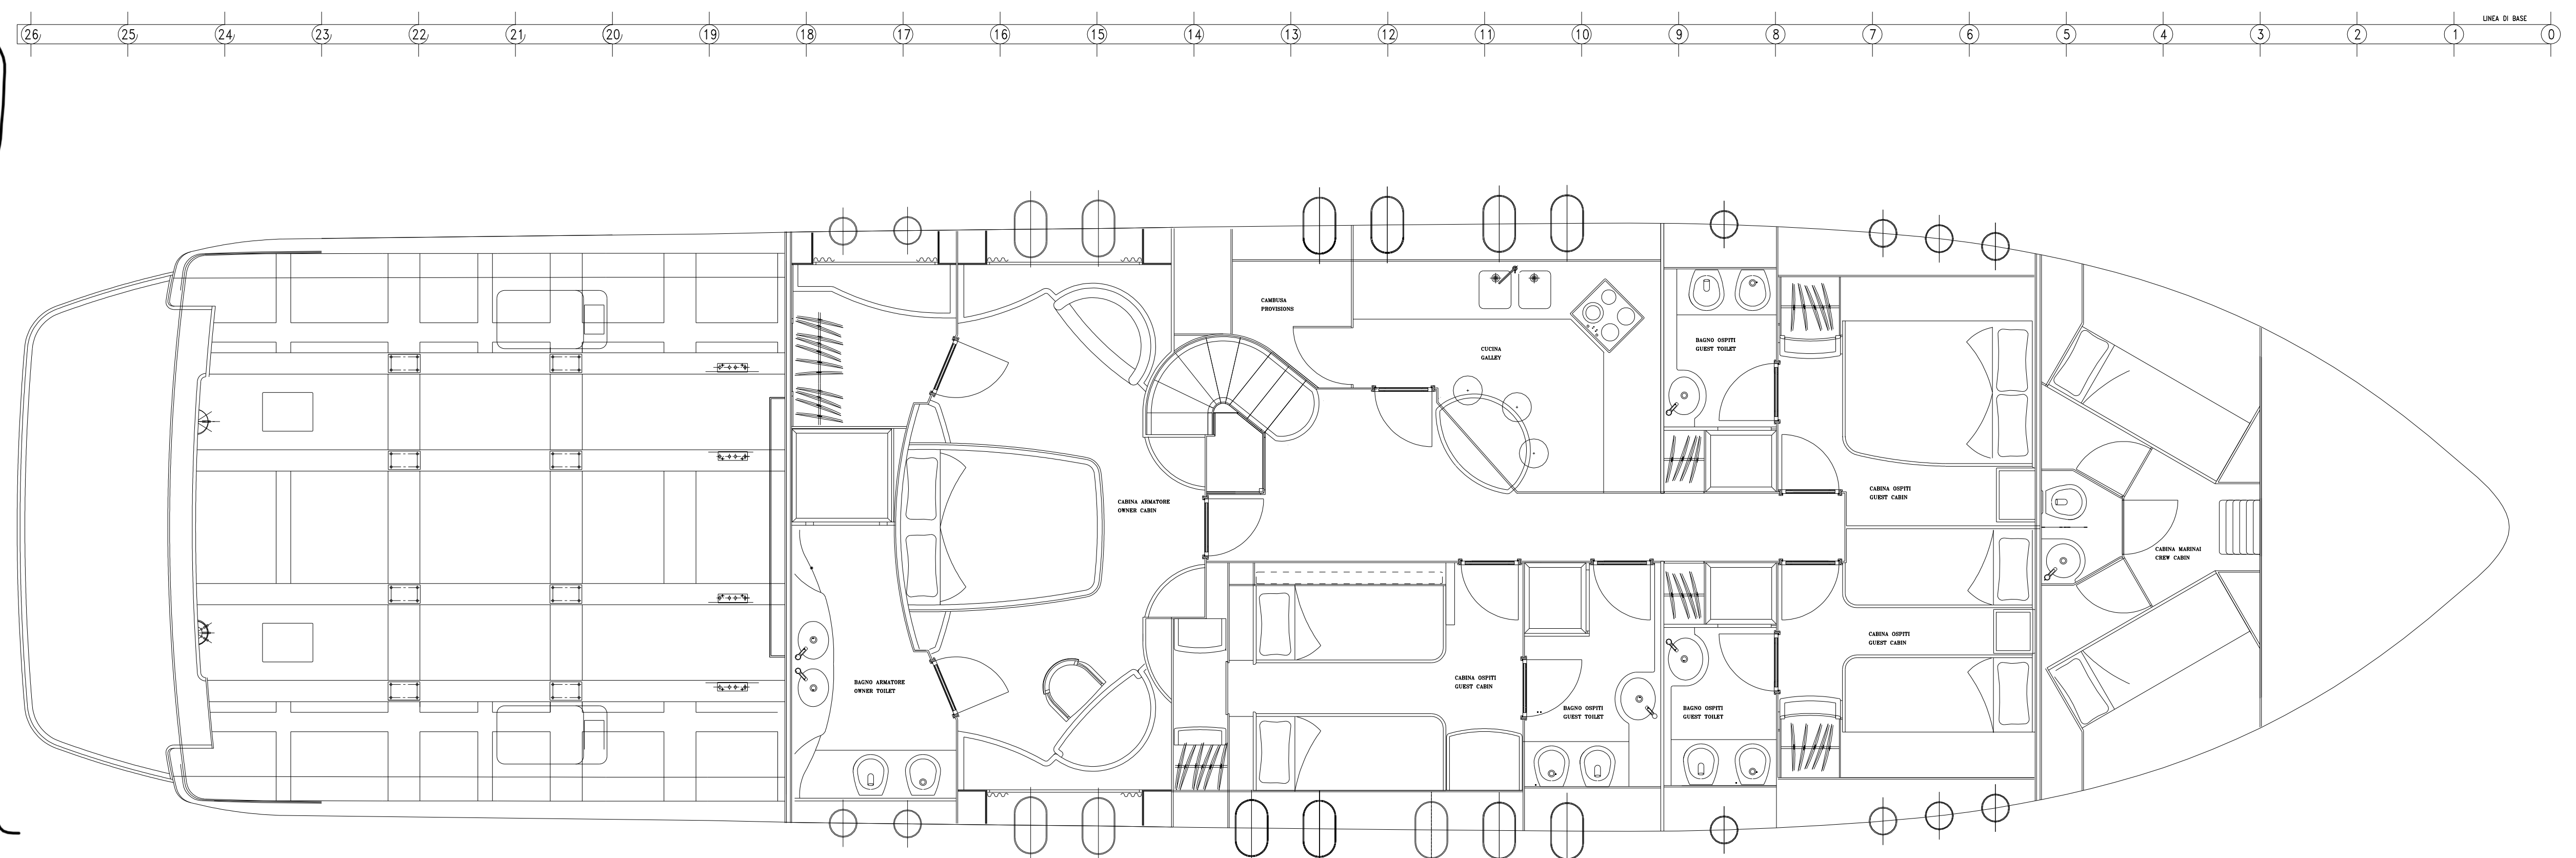

PIANTA ZONA NOTTE - LOWER DECK

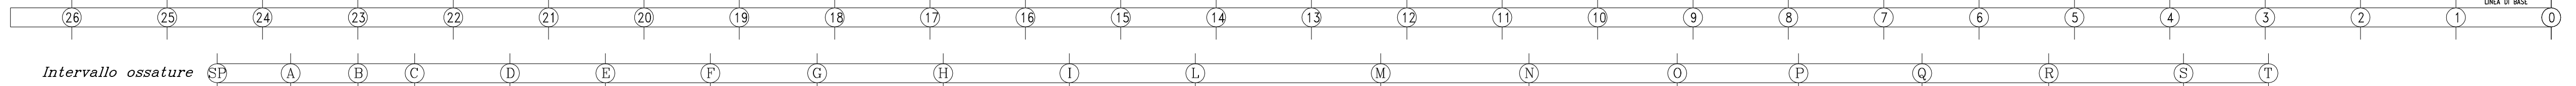

Intervallo ossature (A) (B) (C) (D) (E) (F) (G) (H) (I) (L) (M) (N) (O) (P) (Q) (R) (S) (T)

DP 80'

Dalla Pieta' Yachts

<p>DALLAPIETA' YACHTS Architettura Nautica</p>	<p>Dalla Pieta' Yachts s.r.l. Via del Cavaliere, 12 20022 Montecarlo - Venezia (Italy) Tel. +39 041 692444 (4) Fax +39 041 692622 ufficioclienti@dallapieta.it - www.dallapieta.it</p>	<p>SCALE 1:40 DATE 28-09-2004 DRAWN N38 CHECKED BY Dalla Pieta'</p>	<p>REV. 1/1</p>
	<p>DP PROJECT NO. DP80/2 DRAWING NO. A80-004</p>	<p>AS BUILT QUATTRO CABINE</p>	